


MIDDLE CAMPUS

MARINE CAMPUS

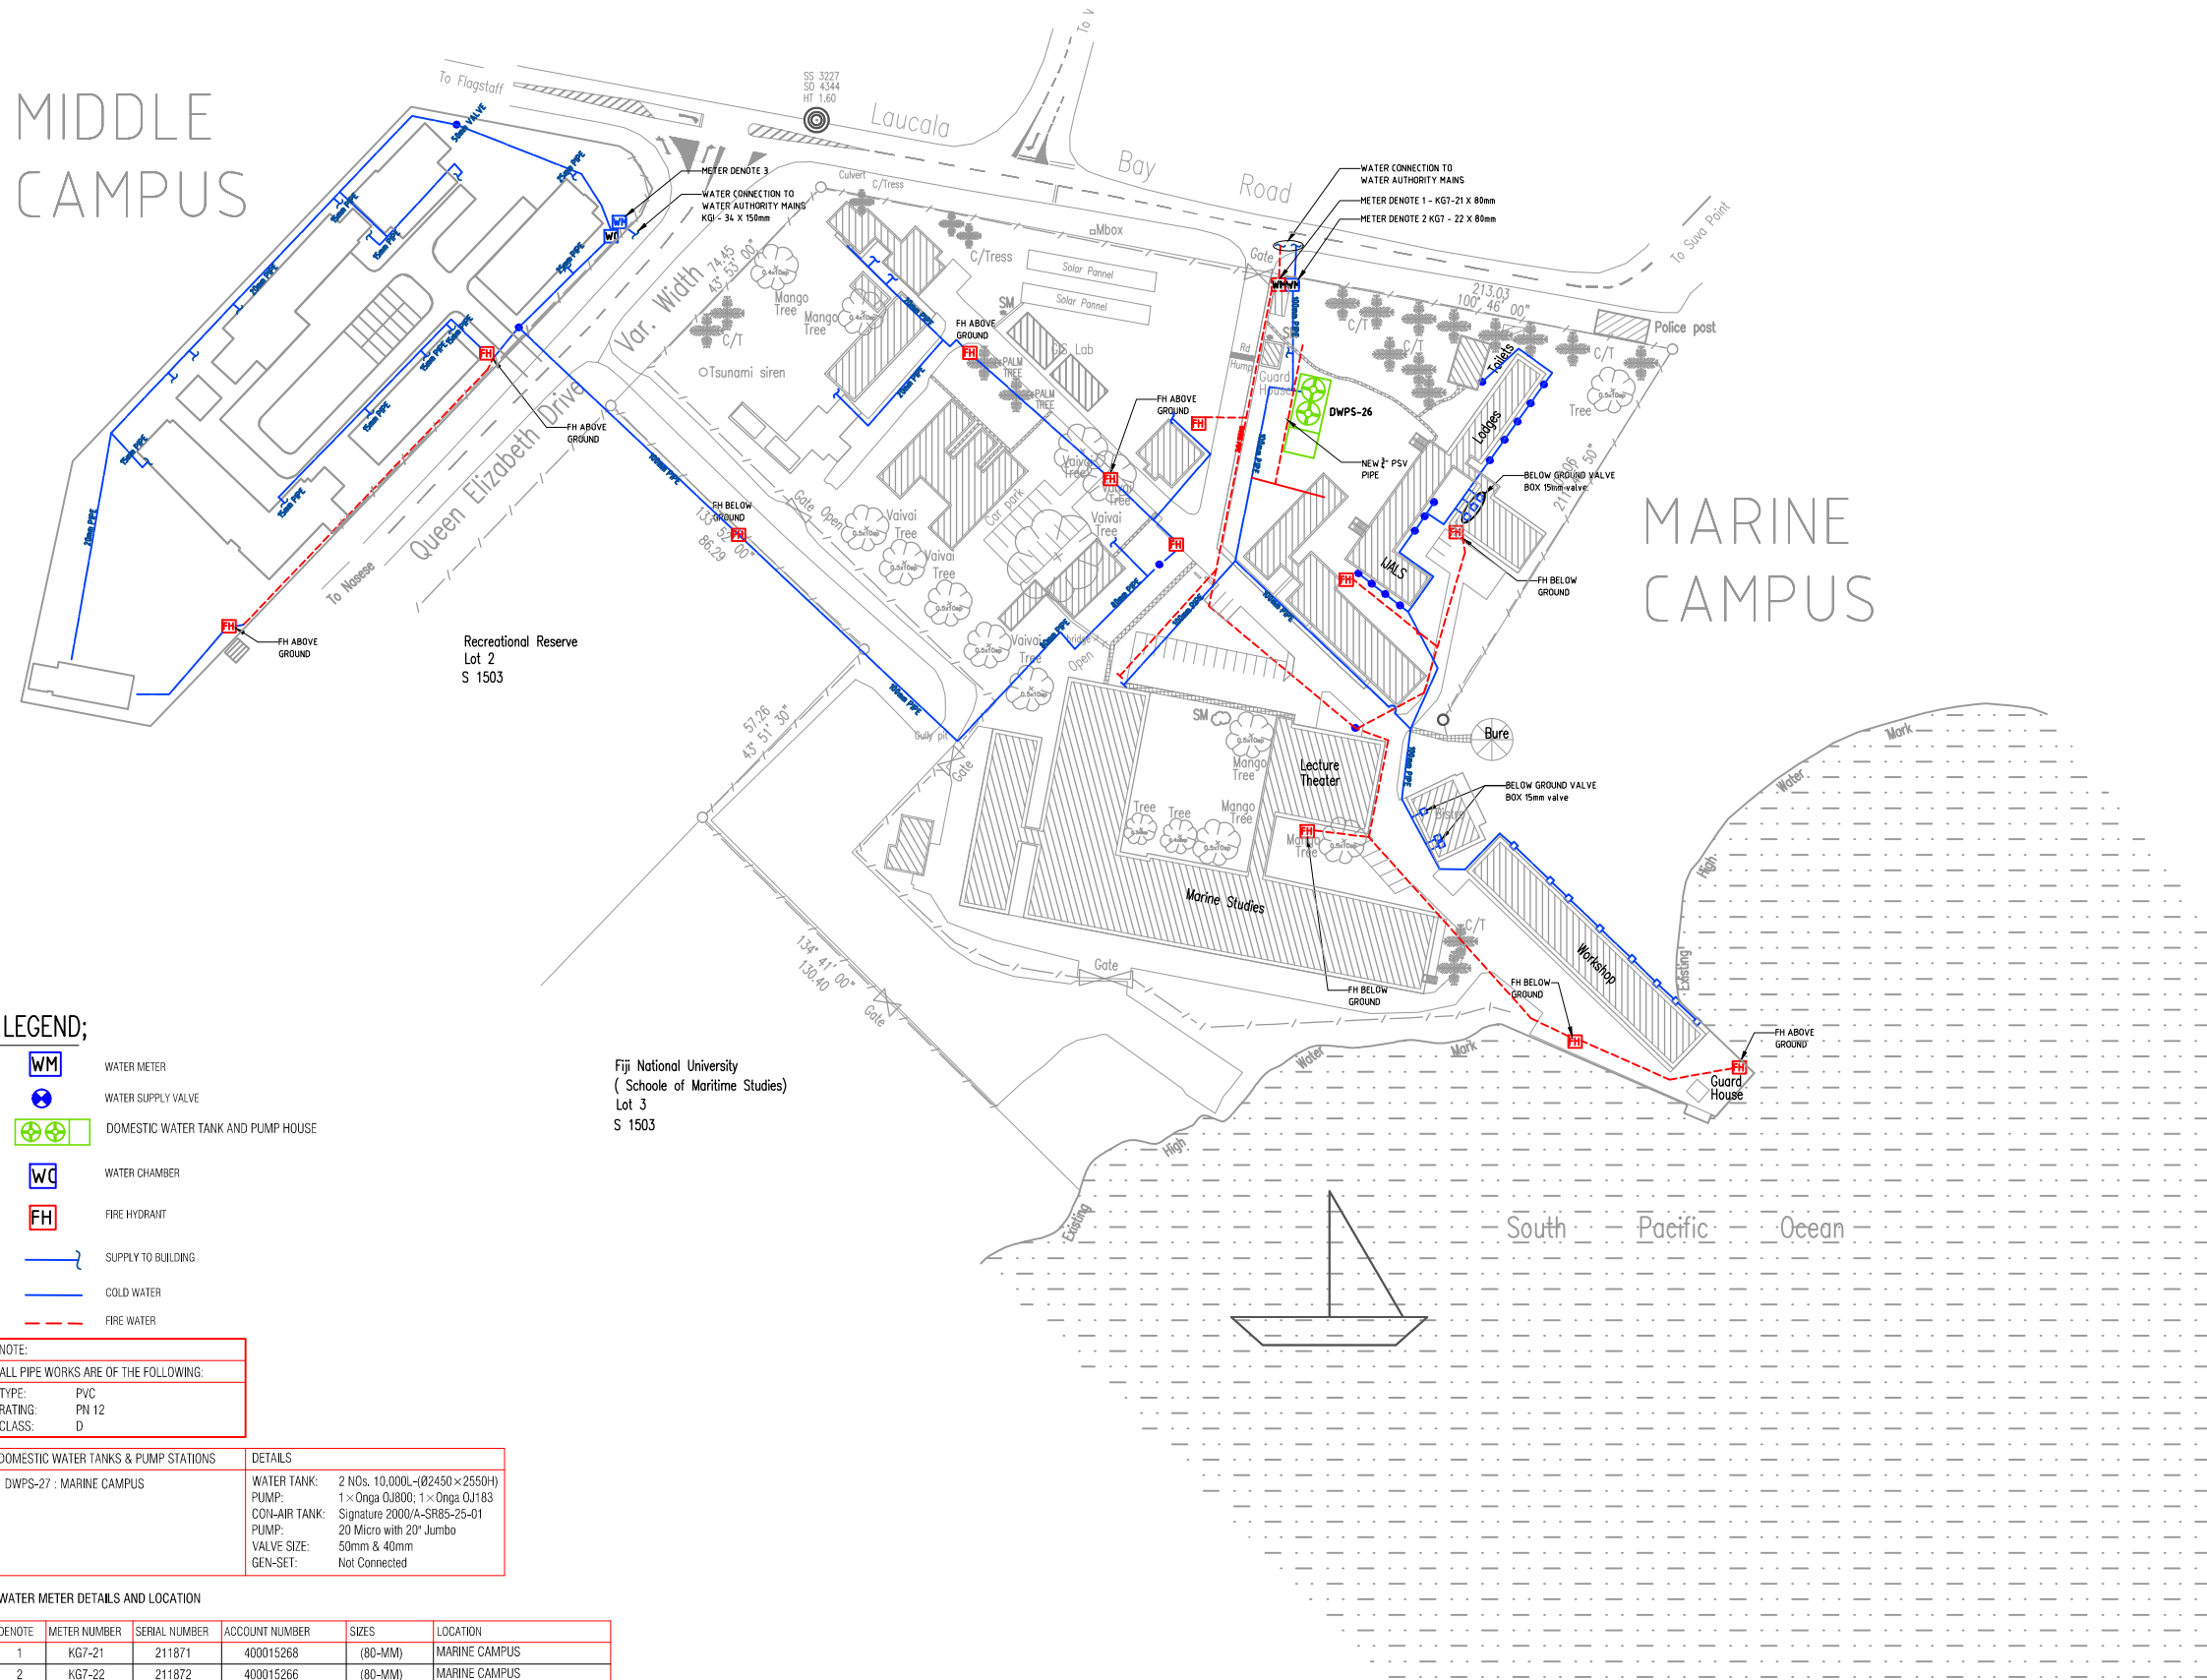

LEGEND:

- WATER METER
- WATER SUPPLY VALVE
- DOMESTIC WATER TANK AND PUMP HOUSE
- WATER CHAMBER
- FIRE HYDRANT
- SUPPLY TO BUILDING
- COLD WATER
- FIRE WATER

NOTE:
 ALL PIPE WORKS ARE OF THE FOLLOWING:
 TYPE: PVC
 RATING: PN 12
 CLASS: D

DOMESTIC WATER TANKS & PUMP STATIONS	DETAILS
DWPS-27 : MARINE CAMPUS	WATER TANK: 2 NOS. 10,000L-(Ø2450x2550H) PUMP: 1x Onga OJ800; 1x Onga OJ183 CON-AIR TANK: Signature 2000/A-SR85-25-01 PUMP: 20 Micro with 20" Jumbo VALVE SIZE: 50mm & 40mm GEN-SET: Not Connected

WATER METER DETAILS AND LOCATION

DENOTE	METER NUMBER	SERIAL NUMBER	ACCOUNT NUMBER	SIZES	LOCATION
1	KG7-21	211871	400015268	(80-MM)	MARINE CAMPUS
2	KG7-22	211872	400015266	(80-MM)	MARINE CAMPUS

Fiji National University
 (Schoole of Maritime Studies)
 Lot 3
 S 1503



© Copyright - UNIVERSITY OF THE SOUTH PACIFIC. No part of this document may be reproduced, stored in a retrieval system in any form or transmitted by any means without prior permission in writing of University of the South Pacific.

CLIENT:
 UNIVERSITY OF THE SOUTH PACIFIC
 ASSETS DATABASE
 LAUCALA CAMPUS, SUVA

BUILDING SERVICES ENGINEERS

QUANTITY SURVEYORS

APPROVAL:

REVISIONS:

Rev	Date	Revision Notes
D	04.07.18	AS UPDATED BY JO DROVA
C	09.02.18	AS UPDATED BY S.NAND
B	03.06.16	AS-BUILT BY KRAMMER
A	28.04.16	AS-BUILT BY KRAMMER

Dimensions
 Figural dimensions shall take precedence over scaled dimensions and larger scale drawings over smaller scale drawings.
 Check on Site
 Check all dimensions on site before commencing work and before producing shop drawings. Notify the architect of any discrepancies.

PROJECT:
 MID & MARINE CAMPUS
 SERVICES
 AS-BUILT DRAWINGS -
 UPDATE
 UNIVERSITY OF THE SOUTH PACIFIC
 MID & MARINE CAMPUS.
 DRAWING TITLE:
 HYDRAULICS SERVICES
 WATER SERVICES LAYOUT

DRAWING STATUS:
AS BUILTS

Issue Date: Feb 2018	Drawn: SNL
Project Design:	Checked By: Jt
Project Number : 16091F	

DRAWING NUMBER: HO1	REVISION D
-------------------------------	----------------------

1 HYDRAULIC SERVICES LAYOUT - WATER SERVICES LAYOUT

SCALE 1:500 @ A1