

D	04.07.18	UPDATED ASBUILT BY JO DROVA
C	09.02.18	UPDATED BY S.NAND
B	03.06.16	AS BUILT BY KRAMMER
A	28.04.16	AS BUILT BY KRAMMER
Rev:	Date:	Revision Notes

Dimensions
Figural dimensions shall take precedence over scaled dimensions and larger scale drawings over smaller scale drawings.
Check on Site
Check all dimensions on site before commencing work and before producing shop drawings. Notify the architect of any discrepancies.

PROJECT:
STATHAM CAMPUS SERVICES AS-BUILT DRAWINGS - UPDATE
UNIVERSITY OF THE SOUTH PACIFIC
STATHAM CAMPUS.
DRAWING TITLE:
HYDRAULICS SERVICES WATER SERVICES LAYOUT

DRAWING STATUS:
AS BUILTS

Issue Date:	July 2018	Drawn:	SNL
Project Design:		Checked By:	Jt
Project Number:	16091F		

DRAWING NUMBER:	H01	REVISION	D
-----------------	------------	----------	----------

LEGEND:


- WATER METER
- WATER SUPPLY VALVE
- DOMESTIC WATER TANK AND PUMP HOUSE
- WATER CHAMBER
- FIRE HYDRANT
- SUPPLY TO BUILDING
- COLD WATER
- FIRE WATER

NOTE:
ALL PIPE WORKS ARE OF THE FOLLOWING:
TYPE: PVC
RATING: PN 12
CLASS: D

DOMESTIC WATER TANKS & PUMP STATIONS	DETAILS
DWPS-26 : STATHAM CAMPUS	WATER TANK: 2 Nds. 10,000L (Ø2450 x 2550H) PUMP: 1 x Omega QJ800; 1 x Omega QJ183 CON-AIR TANK: Signature 2000A-SR85-25-01 PUMP: 20 Micro with 20" Jumbo VALVE SIZE: 50mm & 40mm GEN-SET: Connected

WATER METER DETAILS AND LOCATION

DENOTE	METER NUMBER	SERIAL NUMBER	ACCOUNT NUMBER	SIZES	LOCATION
1	KGB 11	C39W029990	108021041	(50-MM)	STATHAM CAMPUS
2	KGB 28	14H400205	400026246	(80-MM)	STATHAM CAMPUS

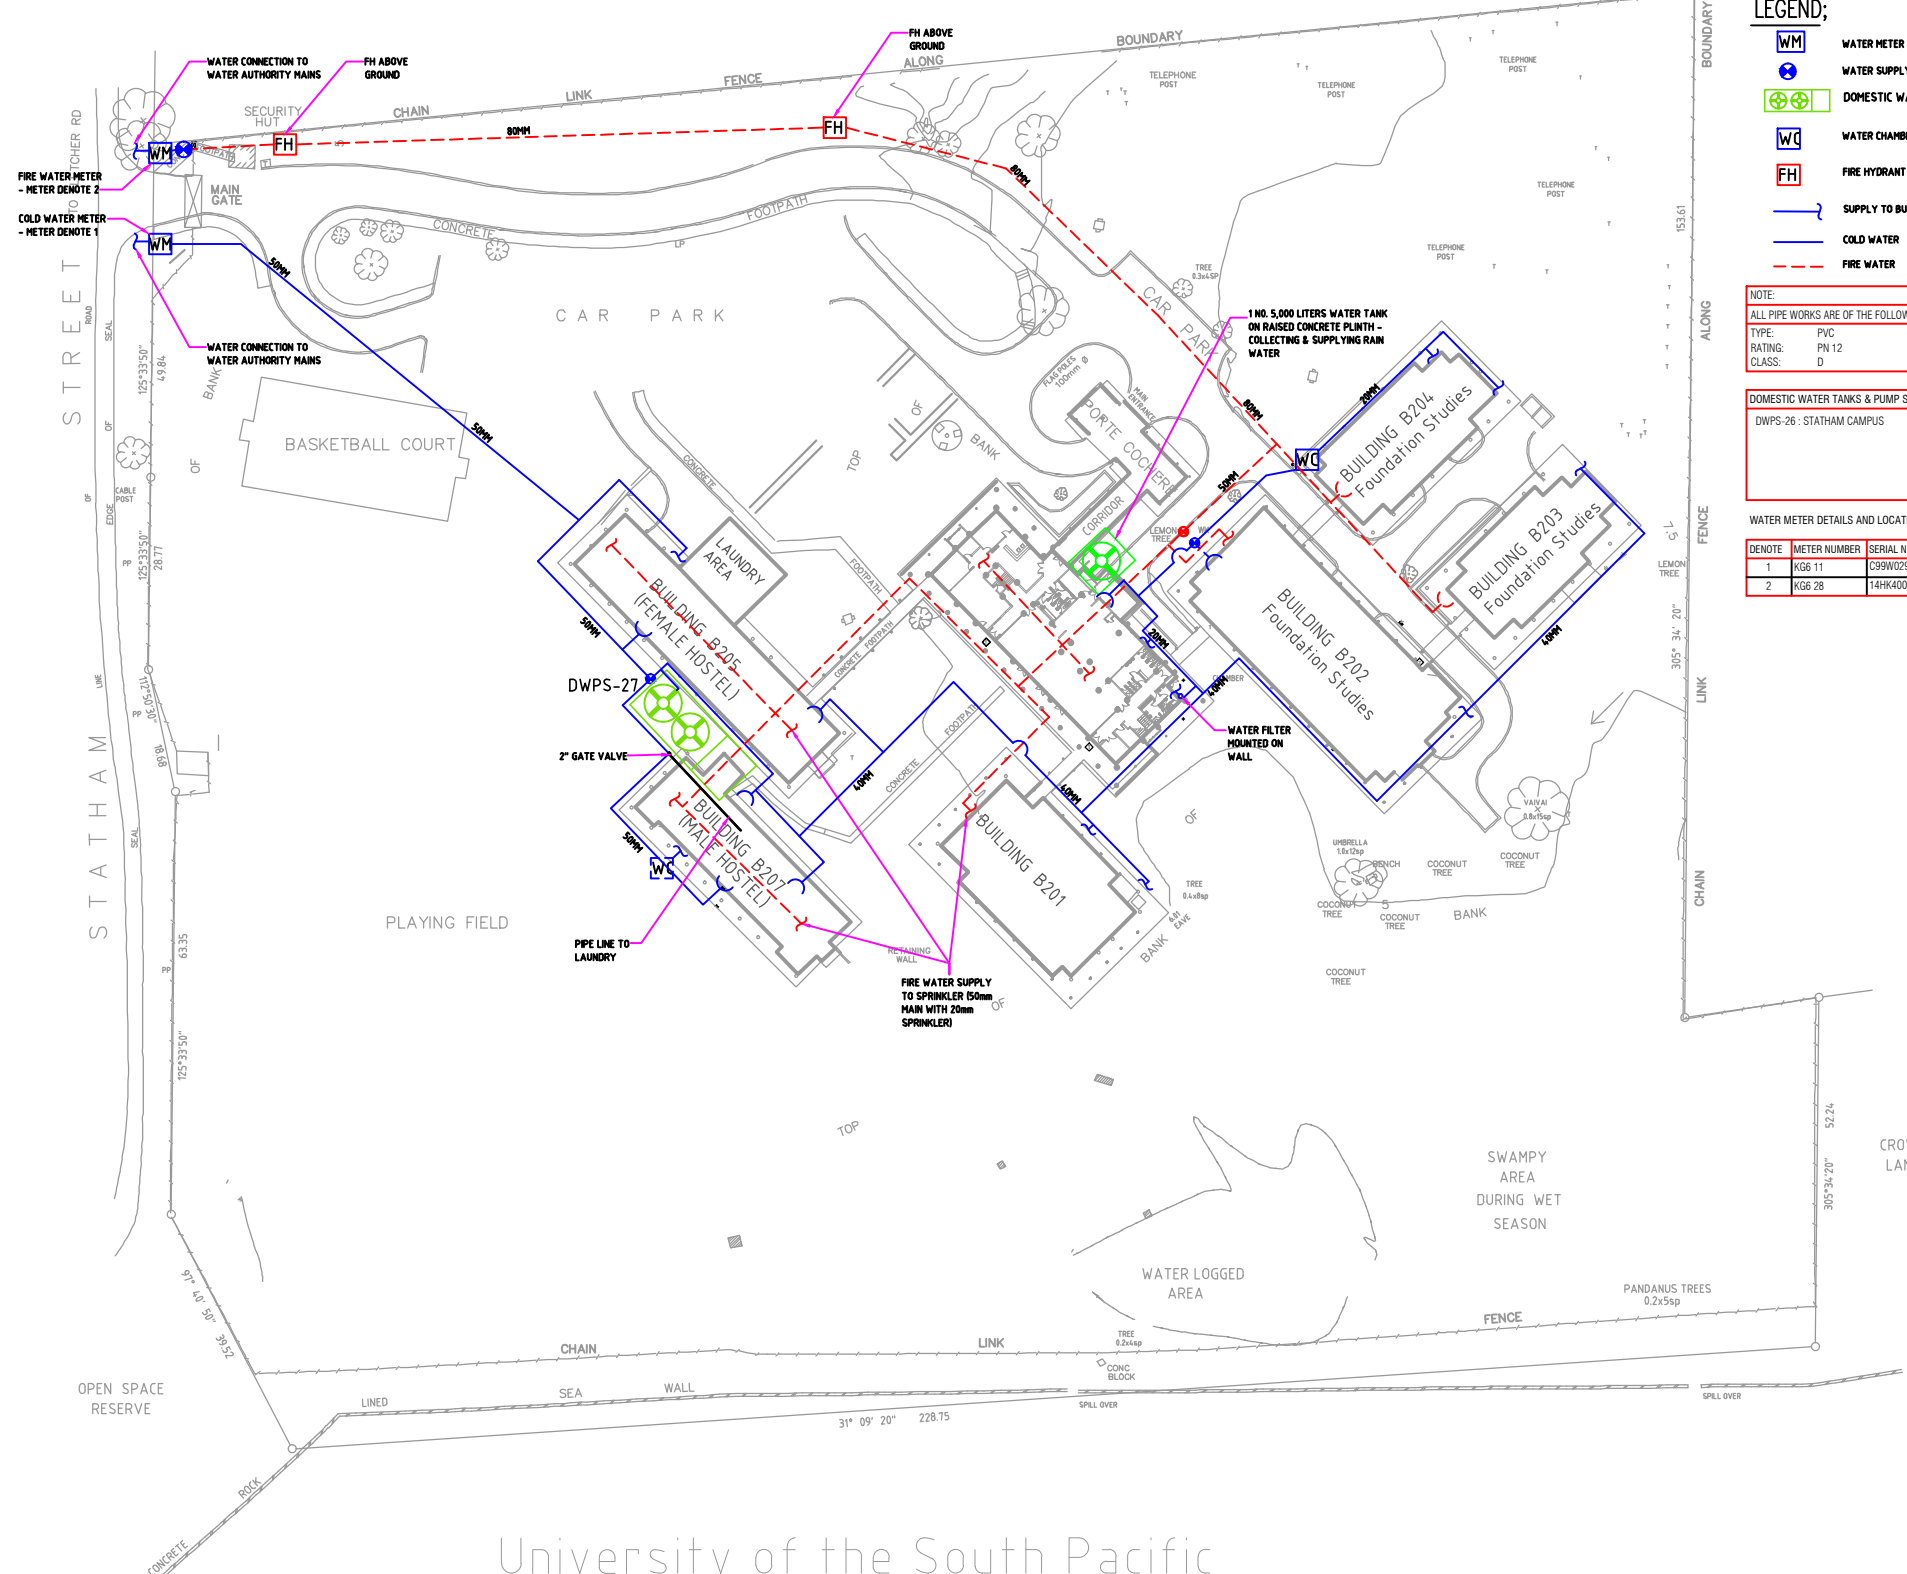

University of the South Pacific

1 HYDRAULIC SERVICES LAYOUT - WATER SERVICES LAYOUT
SCALE 1:500 @ A1