

© Copyright - UNIVERSITY OF THE SOUTH PACIFIC  
No part of this document may be reproduced, stored in a retrieval system in any form or transmitted by any means without prior permission in writing to the University of the South Pacific.

CLIENT:

CONSULTANTS:  
STRUCTURAL ENGINEER:

BUILDING SERVICES ENGINEER:  
QUANTITY SURVEYOR:

APPROVAL:

E&I CONSULTANT (S.NAND)  
MANAGER OPERATION  
DESIGN CO-ORDINATOR

REVISION:

| NO. | DATE     | DESCRIPTION          | BY |
|-----|----------|----------------------|----|
| C   | 15.01.18 | AS UPDATED BY S.NAND | EJ |
| B   | 03.06.16 | AS BUILT BY KRAMMER  |    |
| A   | 28.04.16 | AS BUILT BY KRAMMER  |    |

Rev. Date: Revision Notes: By:

Dimensions:  
Figured dimensions shall take precedence over scaled dimensions and larger scale drawings over smaller scale drawings.  
Check on site.  
Check all dimensions on site before commencing work and before producing shop drawings. Notify the architect of any discrepancies.


PROJECT:  
**LAUCALA CAMPUS SERVICES AS-BUILTS DRAWINGS**  
UNIVERSITY OF THE SOUTH PACIFIC  
STATHAM CAMPUS

DRAWING TITLE:  
**HYDRAULICS SERVICES - SEWER & STORM WATER LAYOUT**

DRAWING STATUS:  
**FOR APPROVAL**

|                 |               |             |       |
|-----------------|---------------|-------------|-------|
| Issue Date:     | Jan 2018      | Drawn:      | EJ    |
| Project Design: |               | Checked By: | SN/JT |
| Project Number: | <b>16091F</b> |             |       |

DRAWING NUMBER: **H02**      REVISION: **C**

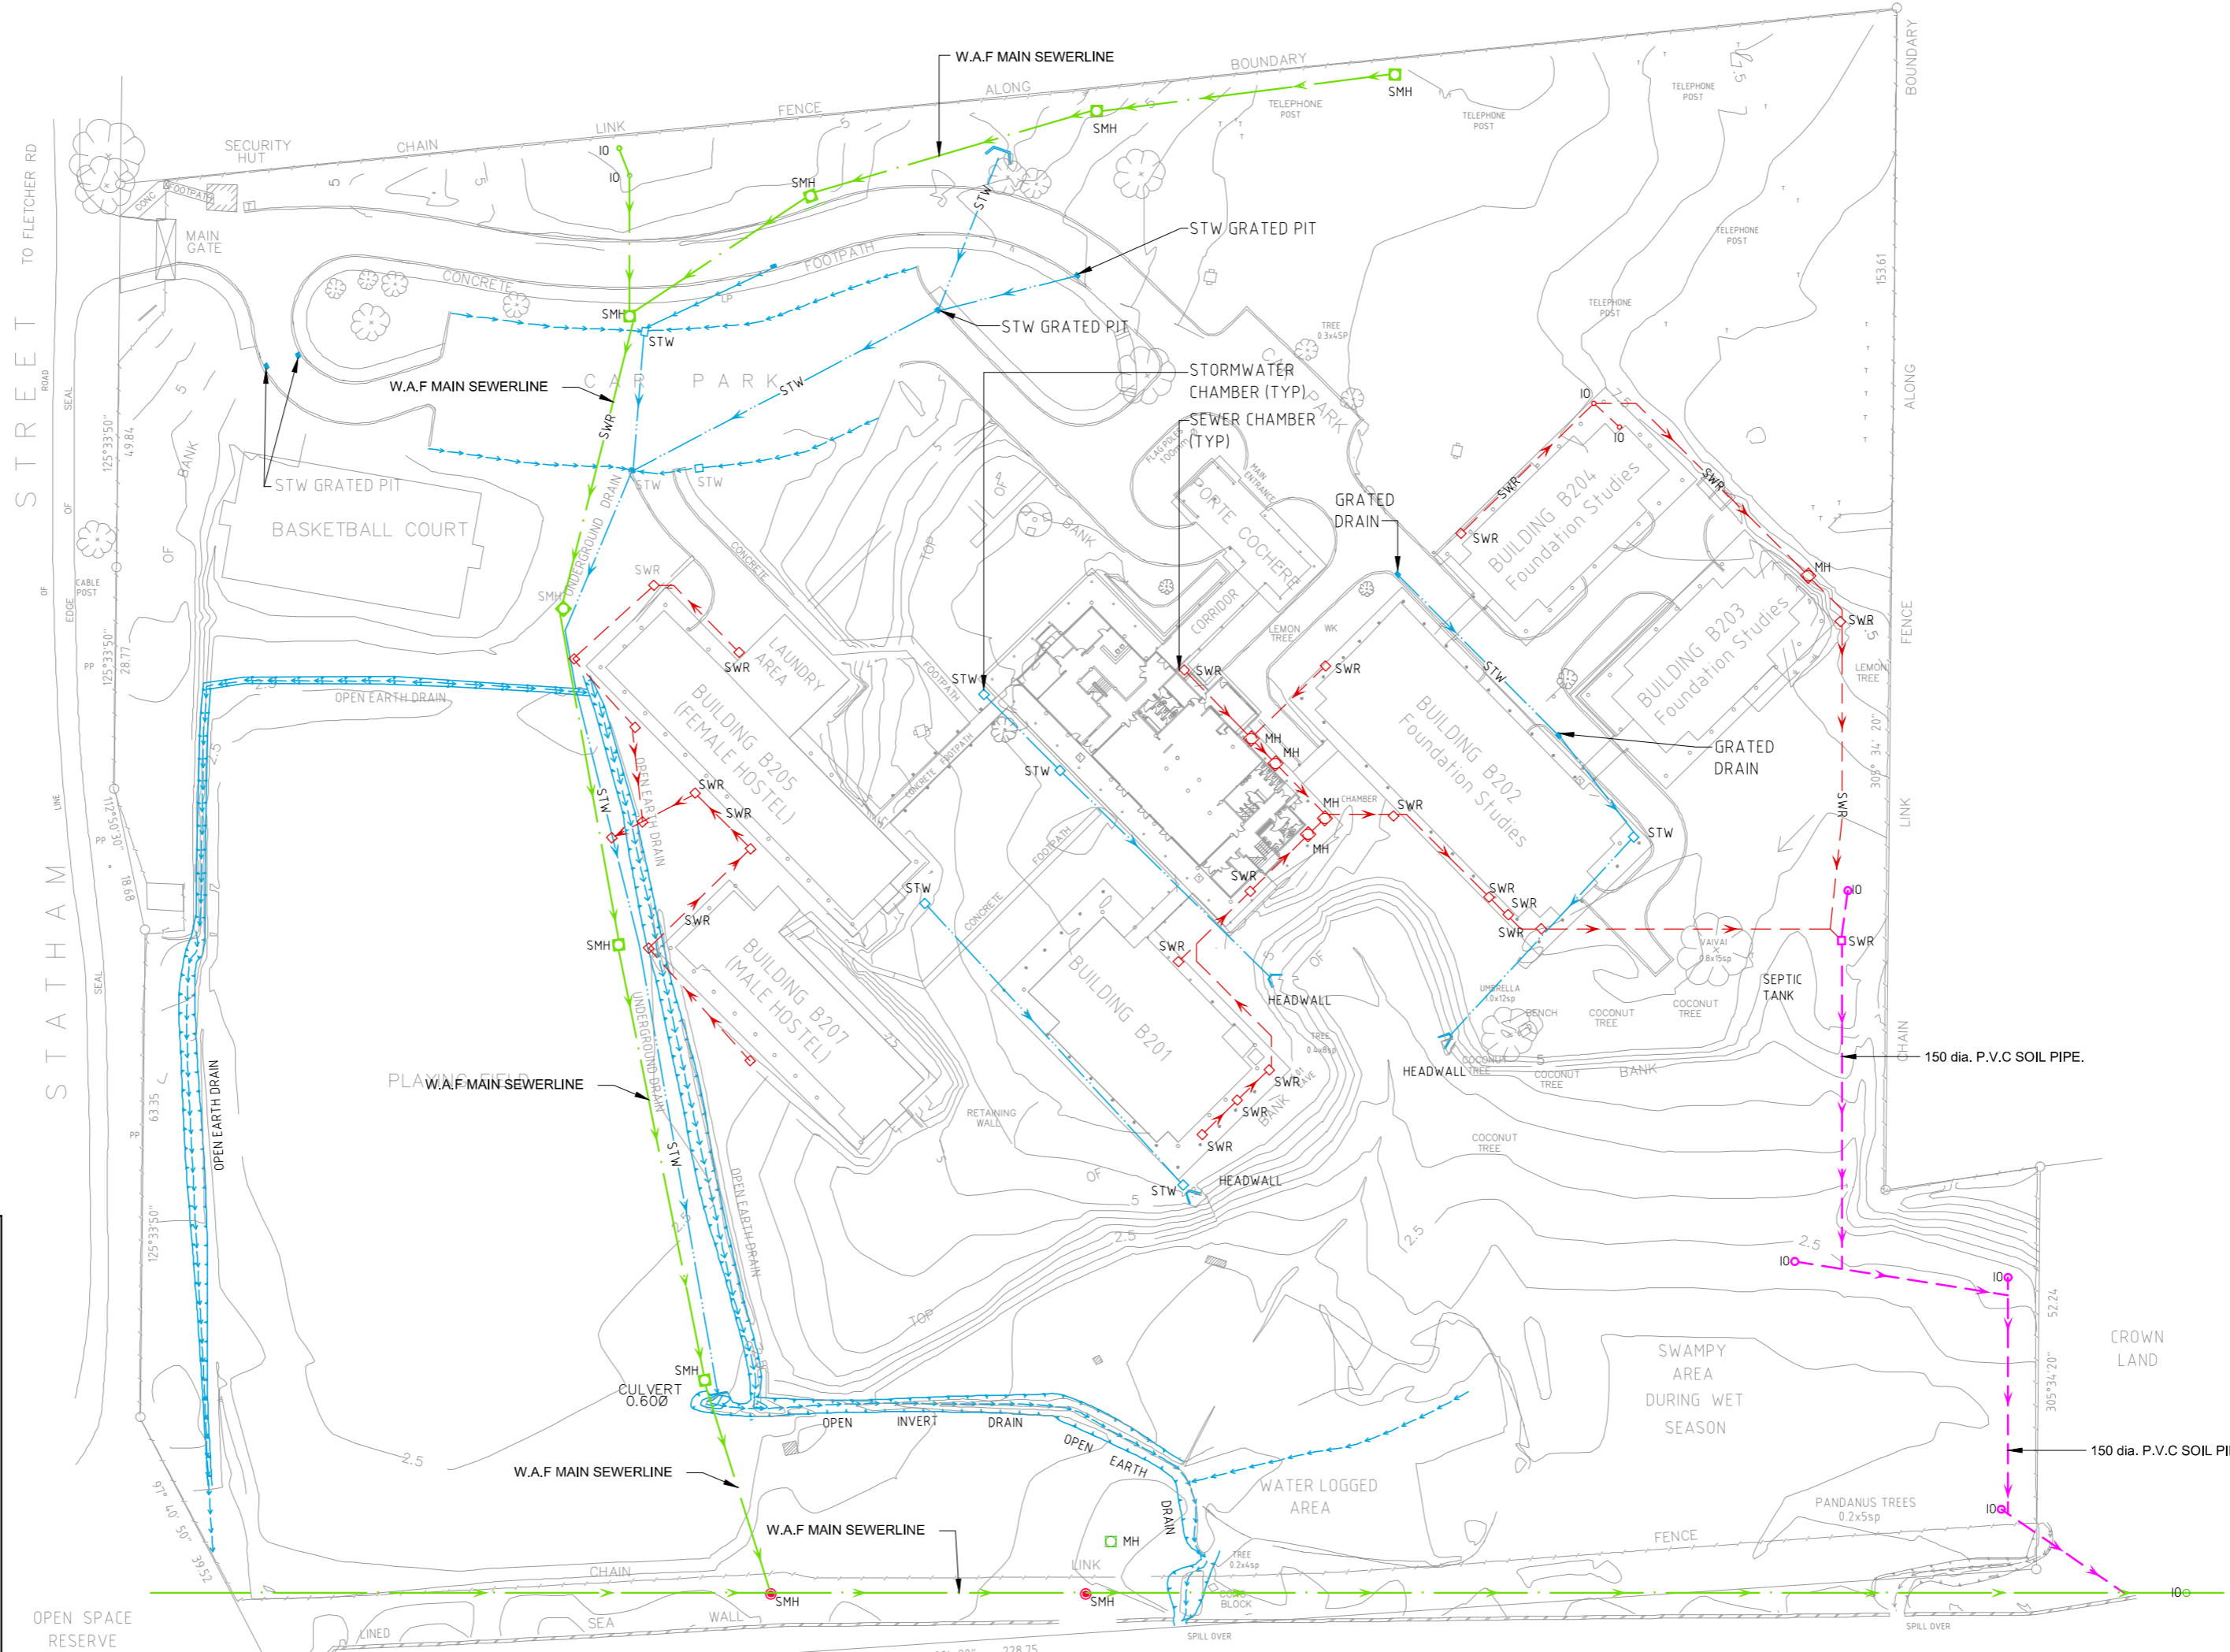

**LEGEND:**

- IO ○ INSPECTION OPENING
- MH □ MANHOLE
- SMH ● COUNCIL SEWER MANHOLE
- STW □ STORMWATER CHAMBER
- SWR □ SEWER CHAMBER
- DRAINS
- TOP OF BANK
- TOP OF OPEN EARTH DRAINS
- STORMWATER HEADWALL
- BELOW GROUND STORMWATER LINE
- BELOW GROUND SEWER LINE W.A.F. MAIN SEWERLINE
- 150 DIA. SOIL PIPE.
- 100 DIA. SOIL PIPE.

University of the South Pacific  
Statham Campus

**1** HYDRAULIC SERVICES LAYOUT -  
SEWER & STORM WATER      SCALE 1:500 @ A1