

Rev.	Date:	Revision Notes	By:
A	03.08.2018	As Built	SNL

Dimensions:  
Figured dimensions shall take precedence over scaled dimensions and larger scale drawings over smaller scale drawings.  
Check on Site  
Check all dimensions on site before commencing work and before producing shop drawings. Notify the architect of any discrepancies.

PROJECT:  
**DISABILITY ACCESS ROUTE, ACCESSIBLE BUILDING & FOOTPATH FOR STATHAM CAMPUS**  
UNIVERSITY OF THE SOUTH PACIFIC

DRAWING TITLE:  
**SITE PLAN - STATHAM CAMPUS**

DRAWING STATUS:  
**AS - BUILT**



Issue Date: August 2018  
Drawn: SNL


Project Design:  
Checked By: JT

Project Number: 110

DRAWING NUMBER: **A1** REVISION: **A**

**LEGENDS**

-  Disability Access Route
-  Car Parking
-  Disable Parking
-  Inaccessible Building
-  Accessible Building
-  Limited Accessibility Building

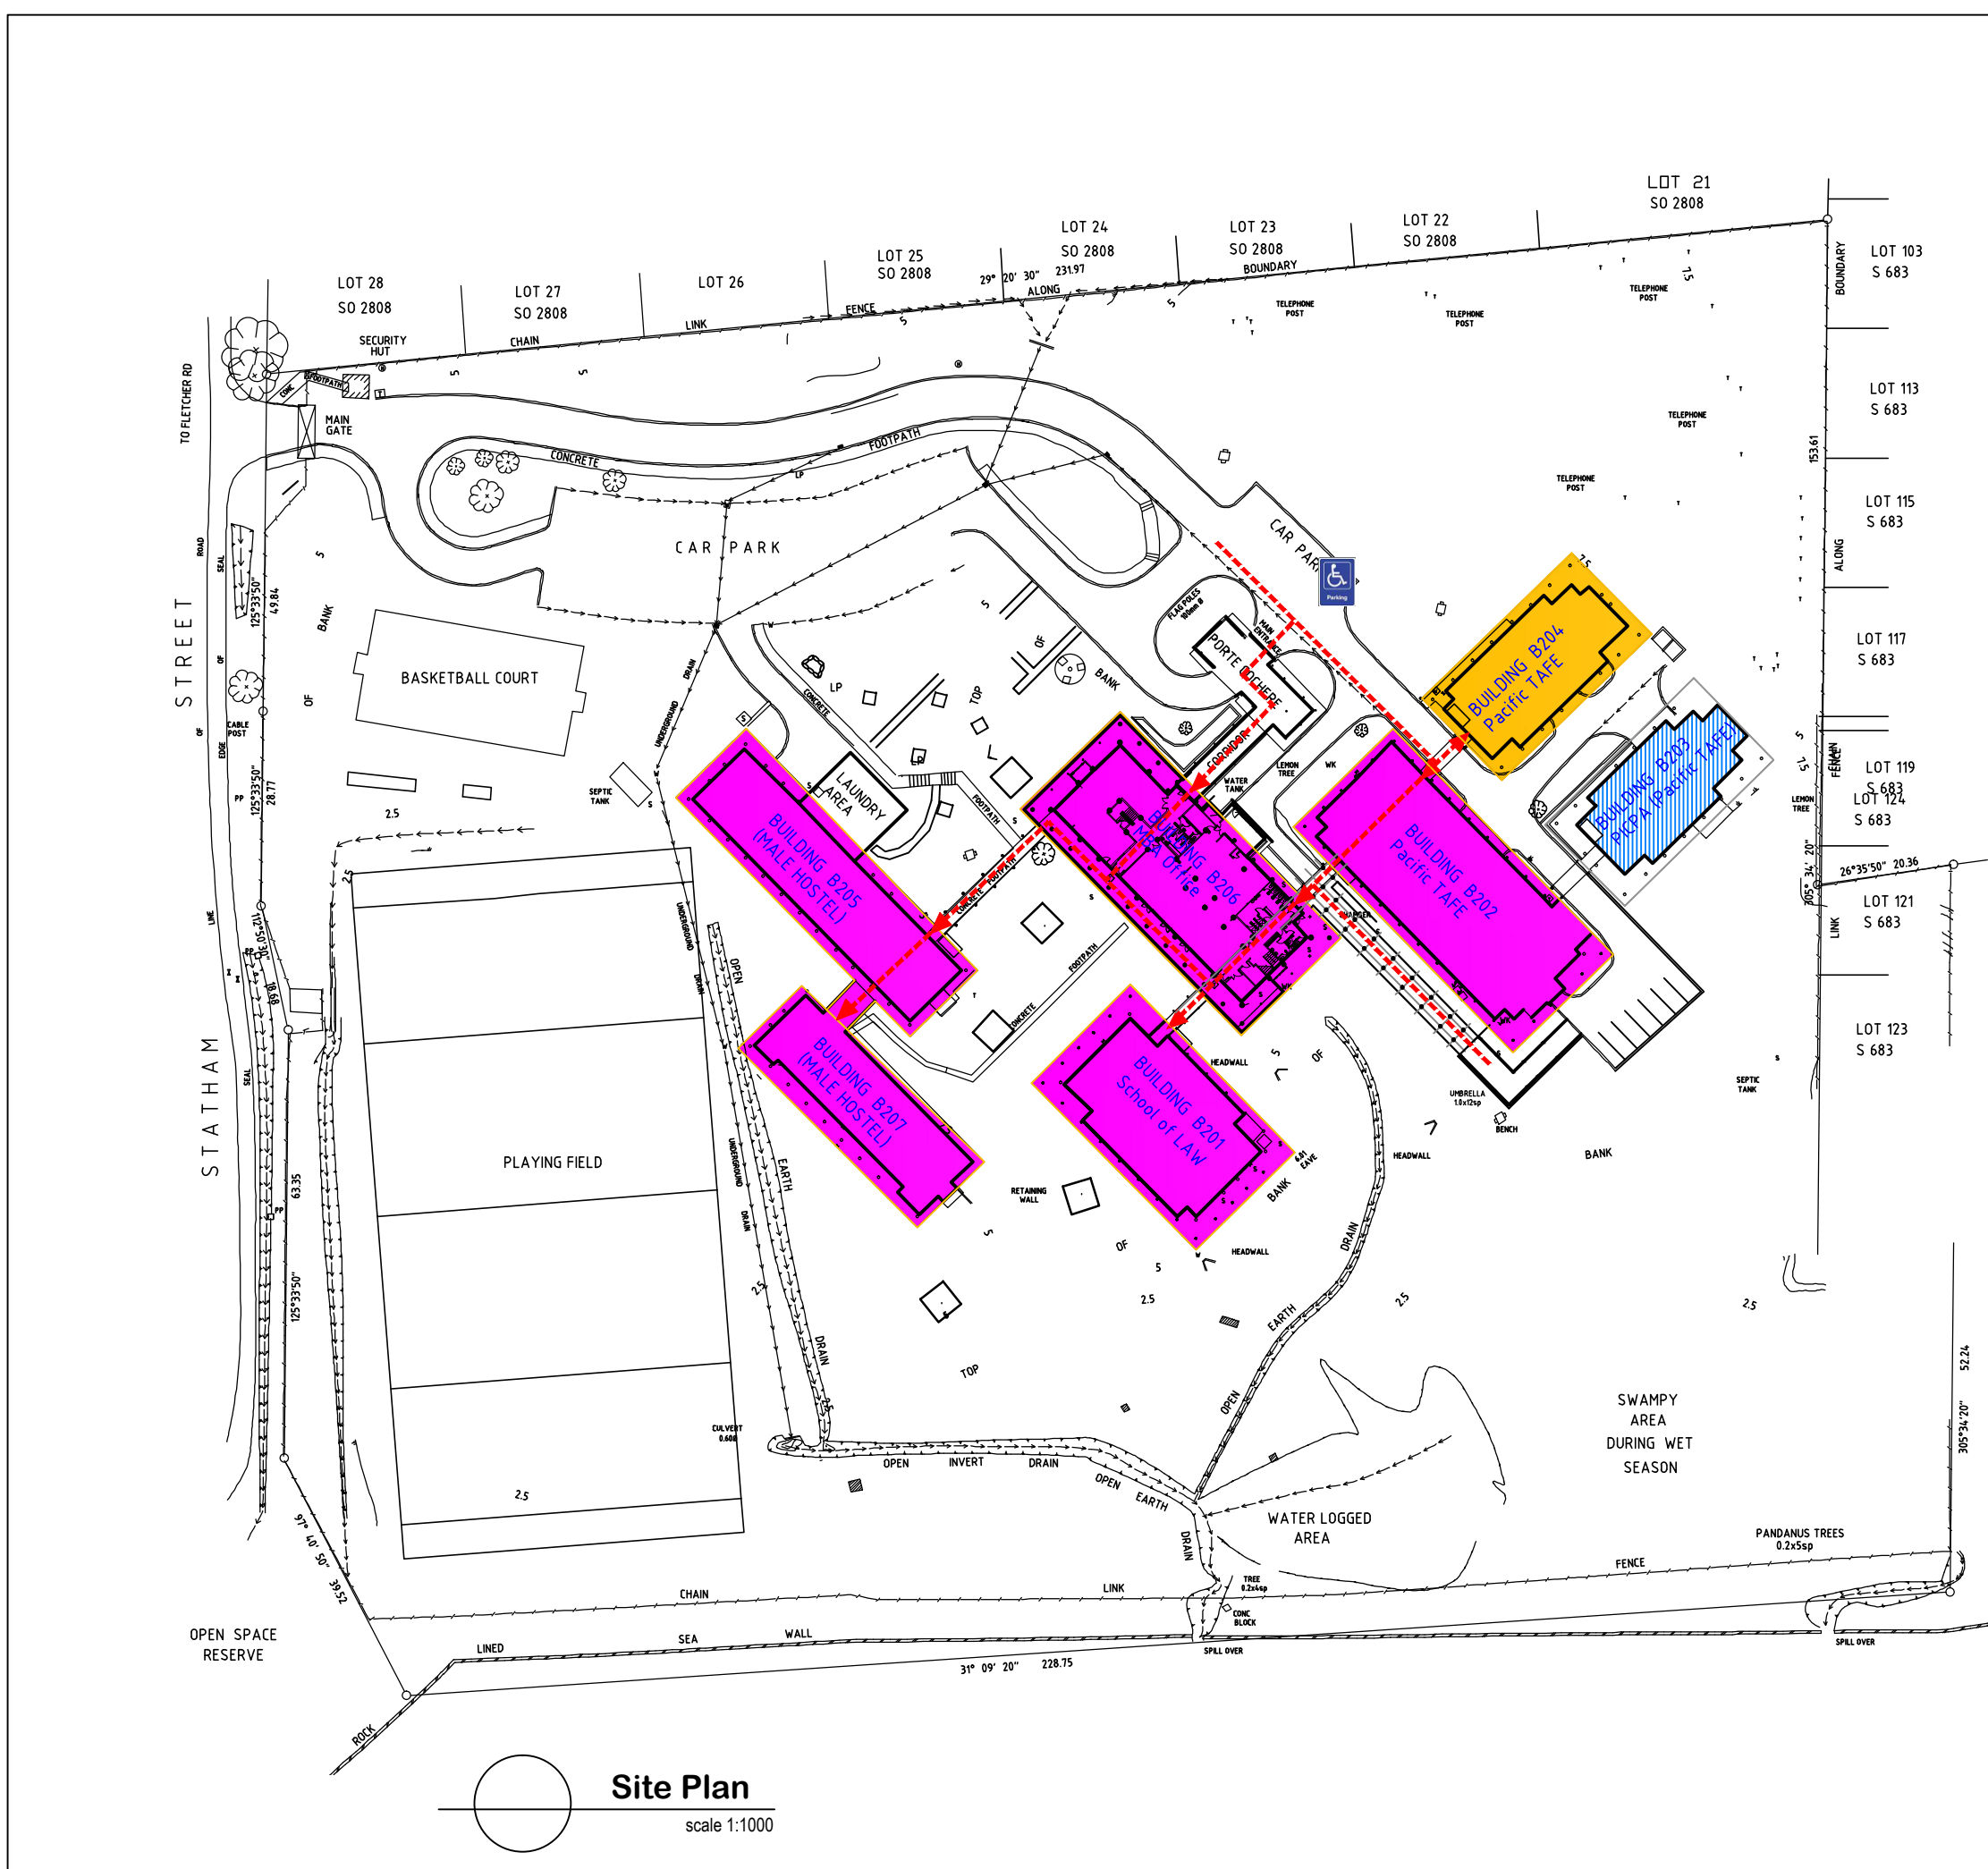

**Site Plan**  
scale 1:1000