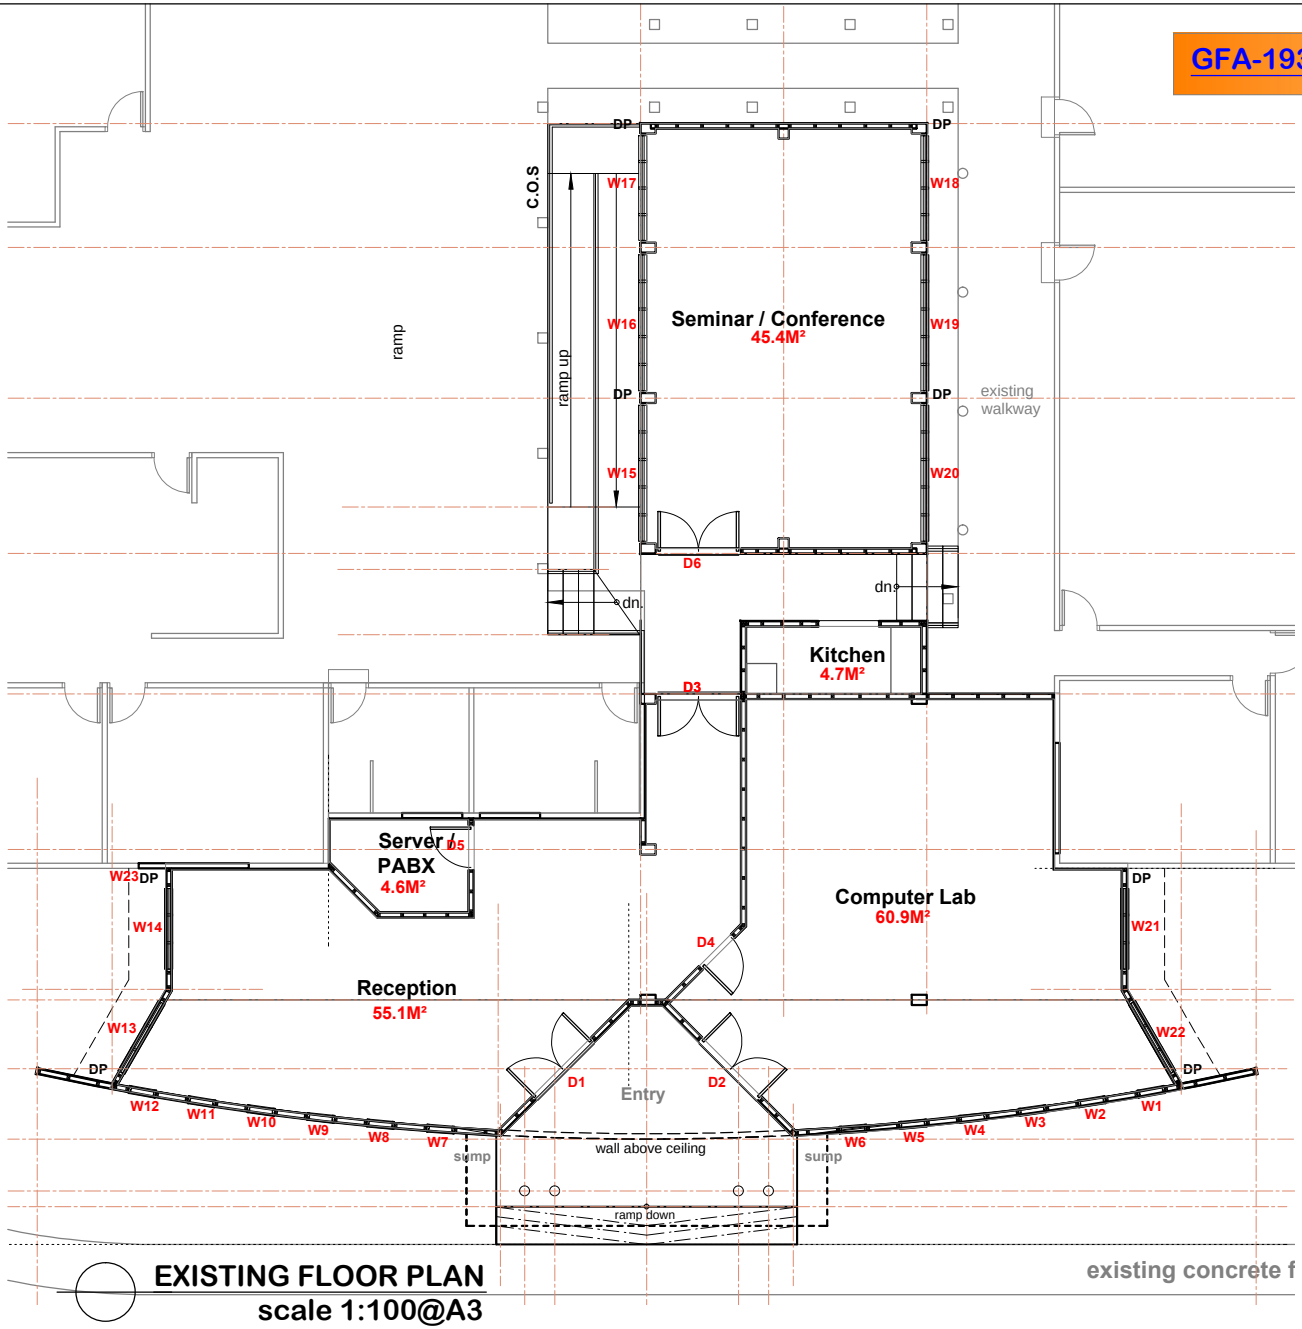

EXISTING FLOOR PLAN
scale 1:100@A3

REFERENCE :

REV. NO	DATE	REVISION DESCRIPTION

CLIENT:
USP
THE UNIVERSITY OF THE SOUTH PACIFIC

PROJECT:
AS BUILT PLAN FOR COOK ISLAND CAMPUS
UNIVERSITY OF THE SOUTH PACIFIC
COOK ISLAND CAMPUS.

© Copyright - UNIVERSITY OF THE SOUTH PACIFIC
No part of this document may be reproduced, stored in a retrieval system in any form or transmitted by any means without prior permission in writing of University of the South Pacific

DATE: June 2016
SCALE: 1:200
DRAWN: suli
CHECKED:
CAD DRAWING DO NOT ALTER
DESIGN:
SHEET TITLE
Existing Floor Plan

JOB NO :	DRAWING NUMBER:	REV. NO :
	A.01	